

June 24, 2021

To: All Prospective Bidders and Plan Holders

Re: Addendum No. 1, Wastewater Treatment Improvements
City of Fort Pierre, SD
BW Project No.: 20301.001

ADDENDUM NO. 1

WASTEWATER TREATMENT IMPROVEMENTS CITY OF FORT PIERRE, SOUTH DAKOTA

This addendum forms a part of the Contract Documents, dated April 2021 Rebid, for the project identified above and modifies, as noted, the original project. Acknowledge receipt of this addendum in the space provided on the Bid Proposal Form. Failure to do so may subject bidder to be disqualified.

This addendum consists of two (2) pages and a fifteen (15) page attachment.

CONTRACT DOCUMENTS AND SPECIFICATIONS

INSTRUCTION TO BIDDERS

Remove ARTICLE 5-PRE-BID CONFERENCE in its entirety and insert the following paragraph.

ARTICLE 5 -- PRE-BID CONFERENCE

- 5.01 A Pre-Bid conference will ~~not~~ be held at Ft. Pierre City Hall on Thursday July 8, 2021 at 9 AM. Representatives of Owner and Engineer will be present to discuss the Project. Bidders are strongly encouraged to attend and participate in the conference. Engineer will transmit to all prospective Bidders of record such Addenda as Engineer considers necessary in response to questions arising at the conference. Oral statements may not be relied upon and will not be binding or legally effective.

BID FORM

Remove the BID FORM in its entirety and insert the attached BID FORM (10 pages).

Changes include the following:

- Base Bid --Line item #22 inserts Sump Pit in description.
- Base Bid --Line item #24 and #25 removes epoxy coating from air headers.
- Alternate Bid Item #1 --Line item #3 and #4, revises the number of manholes to 6.

AGREEMENT

Remove paragraph 4.02 in its entirety under ARTICLE 4-CONTRACT TIMES and insert the following paragraph.

4.02 Dates for Substantial Completion and Final Payment

The Base Bid Work Will be substantially completed by July 1st, 2022 and the Alternate Bid Work (all items) will be substantially complete by September 1, 2022 and within 150 days after the date when the Contract Times commence to run as provided in Paragraph 2.03 of the General Conditions, and completed and ready for final payment in accordance with Paragraph 14.07 of the General Conditions for the Base Bid Work by August 1st, 2022 and for the Alternate Bid Work (all items) by October 1, 2022. within 180 days after the date when the Contract Times commence to run

Remove the last line of paragraph 4.03 under ARTICLE 4-CONTRACT TIMES and insert the following sentence.

After Substantial Completion, if Contractor shall neglect, refuse, or fail to complete the remaining Work within the Contract Time or any proper extension thereof granted by Owner, Contractor shall pay Owner **\$2,000** for each day that expires after the time specified in Paragraph 4.02 above for completion and readiness for final payment until the Work is completed and ready for final payment.


DRAWINGS

Remove and insert the following Drawings.

Drawing C102(sheet 8) and C500(sheet 37)

Drawing X100(sheet 32), X101(sheet 33), and X103 (sheet 35).

End of Addendum

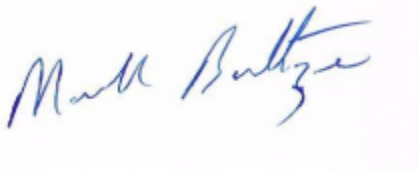

Mark Baltzer, P.E.
Project Engineer



BID FORM
CITY OF FORT PIERRE
WASTEWATER TREATMENT IMPROVEMENTS

TABLE OF CONTENTS

	Page
Article 1 – Bid Recipient.....	1
Article 2 – Bidder’s Acknowledgements.....	1
Article 3 – Bidder’s Representations	1
Article 4 – Bidder’s Certification.....	2
Article 5 – Basis of Bid	3
Article 6 – Time of Completion	6
Article 7 – Attachments to This Bid	6
Article 8 – Defined Terms.....	7
Article 9 – Bid Submittal.....	8

ARTICLE 1 – BID RECIPIENT

1.01 This Bid is submitted to:

**City of Ft. Pierre, City Hall
8 E Second Avenue
Ft Pierre, SD 57532**

1.02 The undersigned Bidder proposes and agrees, if this Bid is accepted, to enter into an Agreement with Owner in the form included in the Bidding Documents to perform all Work as specified or indicated in the Bidding Documents for the prices and within the times indicated in this Bid and in accordance with the other terms and conditions of the Bidding Documents.

ARTICLE 2 – BIDDER’S ACKNOWLEDGEMENTS

2.01 Bidder accepts all of the terms and conditions of the Instructions to Bidders, including without limitation those dealing with the disposition of Bid security. This Bid will remain subject to acceptance for sixty (60) days after the Bid opening, or for such longer period of time that Bidder may agree to in writing upon request of Owner.

ARTICLE 3 – BIDDER’S REPRESENTATIONS

3.01 In submitting this Bid, Bidder represents that:

A. Bidder has examined and carefully studied the Bidding Documents, other related data identified in the Bidding Documents, and the following Addenda, receipt of which is hereby acknowledged:

Addendum No.

Addendum Date

_____	_____
_____	_____
_____	_____

B. Bidder has visited the Site and become familiar with and is satisfied as to the general, local, and Site conditions that may affect cost, progress, and performance of the Work.

C. Bidder is familiar with and is satisfied as to all Laws and Regulations that may affect cost, progress, and of the Work.

D. Bidder has carefully studied all: (1) reports of explorations and tests of subsurface conditions at performance or contiguous to the Site and all drawings of physical conditions relating to existing surface or subsurface structures at the Site (except Underground Facilities) that have been identified in SC-4.02 as containing reliable "technical data," and (2) reports and drawings of Hazardous Environmental Conditions, if any, at the Site that have been identified in SC-4.06 as containing reliable "technical data."

- E. Bidder has considered the information known to Bidder; information commonly known to contractors doing business in the locality of the Site; information and observations obtained from visits to the Site; the Bidding Documents; and the Site-related reports and drawings identified in the Bidding Documents, with respect to the effect of such information, observations, and documents on (1) the cost, progress, and performance of the Work; (2) the means, methods, techniques, sequences, and procedures of construction to be employed by Bidder, including applying the specific means, methods, techniques, sequences, and procedures of construction expressly required by the Bidding Documents; and (3) Bidder's safety precautions and programs.
- F. Based on the information and observations referred to in Paragraph 3.01.E above, Bidder does not consider that further examinations, investigations, explorations, tests, studies, or data are necessary for the determination of this Bid for performance of the Work at the price(s) bid and within the times required, and in accordance with the other terms and conditions of the Bidding Documents.
- G. Bidder is aware of the general nature of work to be performed by Owner and others at the Site that relates to the Work as indicated in the Bidding Documents.
- H. Bidder has given Engineer written notice of all conflicts, errors, ambiguities, or discrepancies that Bidder has discovered in the Bidding Documents, and the written resolution thereof by Engineer is acceptable to Bidder.
- I. The Bidding Documents are generally sufficient to indicate and convey understanding of all terms and conditions for the performance of the Work for which this Bid is submitted.

ARTICLE 4 – BIDDER'S CERTIFICATION

4.01 Bidder certifies that:

- A. This Bid is genuine and not made in the interest of or on behalf of any undisclosed individual or entity and is not submitted in conformity with any collusive agreement or rules of any group, association, organization, or corporation (**other than Bidder**);
- B. Bidder has not directly or indirectly induced or solicited any other Bidder to submit a false or sham Bid;
- C. Bidder has not solicited or induced any individual or entity to refrain from bidding; and
- D. Bidder has not engaged in corrupt, fraudulent, collusive, or coercive practices in competing for the Contract. For the purposes of this Paragraph 4.01.D:
 - 1. "corrupt practice" means the offering, giving, receiving, or soliciting of any thing of value likely to influence the action of a public official in the bidding process;
 - 2. "fraudulent practice" means an intentional misrepresentation of facts made (a) to influence the bidding process to the detriment of Owner, (b) to establish bid prices at artificial non-competitive levels, or (c) to deprive Owner of the benefits of free and open competition;

3. “collusive practice” means a scheme or arrangement between two or more Bidders, with or without the knowledge of Owner, a purpose of which is to establish bid prices at artificial, non-competitive levels; and
4. “coercive practice” means harming or threatening to harm, directly or indirectly, persons or their property to influence their participation in the bidding process or affect the execution of the Contract.

ARTICLE 5 – BASIS OF BID

- 5.01 Bidder will complete the Work in accordance with the Contract Documents for the following price(s):

All specified cash allowances are included in the price(s) set forth below and have been computed in accordance with Paragraph 11.02 of the General Conditions.

Unit Prices have been computed in accordance with Paragraph 11.03.B of the General Conditions.

Bidder acknowledges that estimated quantities are not guaranteed, and are solely for the purpose of comparison of Bids, and final payment for all unit price Bid items will be based on actual quantities, determined as provided in the Contract Documents.

If awarded, the Contract will be awarded per the Bid Documents and for the amount of the Base Bid Price or Alternate Bid Price at the Owner's discretion. Bidder's shall complete the Total Base Bid Price, completing the Alternate Bid Price is at the Bidder's discretion.

The Owner reserves the right to add or deduct any item(s), at the cost(s) shown below, by change order after the award of the Contract.

Item No.	Item	Units	Quantity	Unit Price	Total Price
1	Mobilization	LS	1.0		
LAGOON PIPING IMPROVEMENTS & MODIFICATIONS					
2	16" PVC Gravity Piping, from Intake MH to New Cell #1, w/ Berm Cut, Collar, Compaction & Rip Rap.	LS	1.0		
3	6'-0" Dia FM Intake Manhole at New Cell #1	LS	1.0		
4	12" PVC Gravity MBBR Influent Piping From Cell #3, w/ Berm Cut, Collar & Compaction, Cleanout, & Plug Valve	LS	1.0		
5	12" PVC, MBBR Gravity Effluent Piping to Cell #3, w/ Berm Cut, Collar, Compaction, & Rip Rap	LS	1.0		
6	12" PVC Gravity Sewer, from MBBR to 4' MBBR Effluent Manhole @0.22%	LF	520		
7	4'-0" MBBR Effluent Manhole (near Cell #4)	LS	1.0		
8	10" PVC Forcemain, to New Cell #1 Intake Manhole	LF	100		
9	10" PVC Forcemain From Near Cell #4 to New Cell #1 Intake Manhole	LF	700		
10	10" Plug Valve & Box	EA	3.0		
11	Manual Air Release Assembly on 10" FM	EA	2.0		
12	4" PVC Recirculation Forcemain, From Cell #4 Effluent to New Cell #1 Intake MH	LF	1990		
13	3" PVC Forcemain, Wagon Wheel Extension to New Cell #1 Intake MH	LF	800		
14	3" & 4" Plug Valve & Box	EA	2.0		
15	12" PVC Bypass Line & Plug Valve Between New Cells #1 & #2	LS	1.0		
16	Modify Weir Opening in Existing Control/Outlet Structure of New Cell #2 w/ SS Plate	LS	1.0		
LAGOON EFFLUENT & UV DISINFECTION PIPING & IMP.--NEAR CELL #4					
17	Process Piping --Exterior & Interior UV Disinfection System, Piping, Valves, Fittings, Adapters & Connections to Existing	LS	1.0		
18	Repurpose Existing MH as Recirc MH, New Recirc Pump & Discharge Piping, SS Rail, & Electrical	LS	1.0		
19	Precast UV Disinfection Building (14'x24'), including Foundation, Mechanical, & Electrical	LS	1.0		
20	UV Building Site Grading, Relocate & New Fencing, 16' Gate, and 12' Gravel Access Drive	LS	1.0		
CONTINUED NEXT PAGE					

	CONTINUED FROM PREVIOUS PAGE					
Item No.	Item	Units	Quantity	Unit Price	Total Price	
MBBR TREATMENT BASIN, BLOWER AND AERATION PIPING						
21	MBBR Concrete Influent Structure (6'x 6')& Connecting Piping, and Cover Grate and Installation of Trash Basket	LS	1.0			
22	MBBR CIP Concrete Tanks (18'-4"x 35'-4")& Connecting Piping, Sump Pit, Grate, and Site Grading, Mechanical & Electrical	LS	1.0			
23	MBBR Concrete Effluent Structure (6'x 6')& Connecting Piping, Cover Grate, & Downward Opening SS Slide Gate	LS	1.0			
24	8" DIP MBBR Air Header, CL 56 Double Wrap w/ Poly	LF	145			
25	8" DIP Lagoon Air Header, CL 56 Double Wrap w/ Poly	LF	630			
26	4" HDPE Lagoon Air Header, SDR 17	LF	670			
27	Blower Piping--Interior/Exterior DI Manifold Piping, Valves, Fittings, Adapters, & Connections in Blower Building	LS	1.0			
28	Precast Blower Building (14'x 34'), including Foundation, Site Grading, Mechanical, & Electrical	LS	1.0			
29	Site Electrical for MBBR and UV Disinfection and Blower Building along with Two (2) Transformers	LS	1.0			
30	Temporary Environmental and Erosion Control / SWPPP & NPDES Permit	LS	1.0			
Treatment Equipment Installation and Handling with RFP Equipment Cost						
31	Install UV Disinfection System and Sampler, Mag Meter, Meter Readout, & Controls in UV Building	LS	1.0			
32	Install Blowers, VFDs & Controls in Blower Bldg	LS	1.0			
33	Install MBBR System in CIP Concrete MBBR Tanks, including Aeration Piping, Media, Electric Heater, Insul. Blanket, Sieves, Check Valve & Controls for Complete System	LS	1.0			
34	Install Aerators, Valves and Flexible lines in lagoons New Cells #1 and #2	LS	1.0			
	Subtotal Construction & Equipment Install Project Price				\$	-
35	CONTRACT PRICE ASSIGNED FROM EQUIPMENT RFP	LS	1.0	\$ 1,002,000.00	\$	1,002,000.00
	TOTAL BASE BID PROJECT PRICE					
	CONTINUED NEXT PAGE (ALT BID ITEMS)					

CONTINUED FROM PREVIOUS PAGE					
Item No.	Item	Units	Quantity	Unit Price	Total Price
GRAVITY OUTFALL PIPING (SHT C105 & C106) --Alternate Bid Item #1					
1	12" SDR 21 PVC Gravity Outfall Piping , (pipe material only)	LF	1100		
2	12" SDR 21 PVC Gravity Outfall Piping , Excavation, Compaction Bedding and Pipe Install	LF	1101		
3	4-Foot Dia. Standard Manhole (material only)	EA	6.0		
4	4-Foot Dia. Standard Manhole, Excavation, Compaction, and MH Install	EA	6.0		
5	12" Open Road Crossing & Gravel Repair	EA	1.0		
6	Concrete Outlet Structure	EA	1.0		
TOTAL ALT BID #1 PROJECT PRICE					\$ -
PIPING IMPROVEMENTS AT EXISTING CELLS #1 AND #2 (SHT C100) --ALTERNATE BID ITEM #2					
1	10" PVC Forcemain, at Existing Cells #1 and #2	LF	870		
2	8" Plug Valve and Box	EA	2.0		
3	10" Plug Valve & Box	EA	2.0		
4	Furnish Materials Only for 6'-0" Dia MH (new Pump St. Intake/Wetwell)	EA	1.0		
TOTAL ALT BID #2 PROJECT PRICE					\$ -
SITE IMPROVEMENTS AT LAGOON CELLS #1 #2, #3, & #4 --ALTERNATE BID ITEM #3					
1	Gravel Surface Repair and Plant Road Improvements, Including Gravel Placement, Compaction, & Grading (3" depth)	SY	1450		
2	Concrete CIP Water Markers	EA	4.0		
TOTAL ALT BID #3 PROJECT PRICE					\$ -

ARTICLE 6 – TIME OF COMPLETION

6.01 Bidder agrees that the Work will be substantially complete and will be completed and ready for final payment in accordance with Paragraph 14.07 of the General Conditions on or before the dates or within the number of calendar days indicated in the Agreement.

ARTICLE 7 – ATTACHMENTS TO THIS BID

7.01 The following documents are attached to and made a ~~condition~~ **part** of this Bid:

- A. Required Bid security in the form of **a BID BOND as provided for in the Instructions to Bidders. The Bid Bond envelope must be separate from the envelope containing the Bid Form.**
- B. ~~List of Proposed Subcontractors for the following work:-~~ **The Bidder shall list the names of subcontractor(s) who will be on the job and will state the firm's name and principal**

location of the office of each. A change is subcontractor will not be allowed without the approval of the Owner.

<u>WORK DESCRIPTION</u>	<u>SUBCONTRACTORS</u>	<u>LOCATION</u>
_____	_____	_____
_____	_____	_____

- C. ~~List of Proposed Suppliers for the following items:~~ **The Bidder shall list the manufacturers/suppliers of precast buildings and appurtenances**

<u>DESCRIPTION</u>	<u>SUPPLIER</u>	<u>LOCATION</u>
_____	_____	_____
_____	_____	_____

- D. The CONTRACTOR bidding shall list the type, sizes, pressure classes, and manufacturer of pipe material. Only one pipe material and pipe manufacturer shall be listed for each pipe size and pressure class.

<u>PIPE MATERIAL</u>	<u>-PIPE SIZES & PRESSURE CLASSES</u>	<u>PIPE MANUFACTURER</u>	<u>LOCATION OF PLANT</u>
_____	_____	_____	_____
_____	_____	_____	_____
_____	_____	_____	_____

E. Evidence of authority to do business in South Dakota;

F. Contractor's Excise Tax License

G. Bidders Corporate Acknowledgement

- H. (1)--DBE 6 "DBE Subcontractor Solicitation Information" and (2)--Debar 2 forms "Certification Regarding Debarment, Suspension, and Other Responsibility Matters" and (3)--AIS forms "American Iron and Steel Certification" from the SRF General Conditions, **must be submitted with Bid.** DBE 9 and DBE 11 forms do not need to be submitted with the Bid, but must be submitted to SDDANR within 10 calendar days of the bid opening.

ARTICLE 8 – DEFINED TERMS

- 8.01 The terms used in this Bid with initial capital letters have the meanings stated in the Instructions to Bidders, the General Conditions, and the Supplementary Conditions.

BID SUBMITTAL

9.01 This Bid is submitted by:

If Bidder is:

An Individual

Name (typed or printed): _____

By: _____
(Individual's signature)

Doing business as: _____

A Partnership

Partnership Name: _____

By: _____
(Signature of general partner -- attach evidence of authority to sign)

Name (typed or printed): _____

A Corporation

Corporation Name: _____ (SEAL)

State of Incorporation: _____

Type (General Business, Professional, Service, Limited Liability): _____

By: _____
(Signature -- attach evidence of authority to sign)

Name (typed or printed): _____

Title: _____
(CORPORATE SEAL)

Attest _____

Date of Qualification to do business in South Dakota is ____/____/____.

A Joint Venture

Name of Joint Venture: _____

First Joint Venturer Name: _____ (SEAL)

By: _____
(Signature of first joint venture partner -- attach evidence of authority to sign)

Name (typed or printed): _____

Title: _____

Second Joint Venturer Name: _____ (SEAL)

By: _____
(Signature of second joint venture partner -- attach evidence of authority to sign)

Name (typed or printed): _____

Title: _____

(Each joint venturer must sign. The manner of signing for each individual, partnership, and corporation that is a party to the joint venture should be in the manner indicated above.)

Bidder's Business Address _____


Phone No. _____ Fax No. _____

E-mail _____

SUBMITTED on _____, 20____.

State Contractor License No. _____.

Last edit on: 6/23/2021 10:30 AM by: RJD0471 Drawing Name: V:\000\050\production\Proj 203001\20301.001\AmeCad\Plan Set\20301.001_MBBR Layout.dwg Layout Name: MBBR Layout Plotted By: RJD0471 Plotted on: 6/23/2021 4:32:08 PM

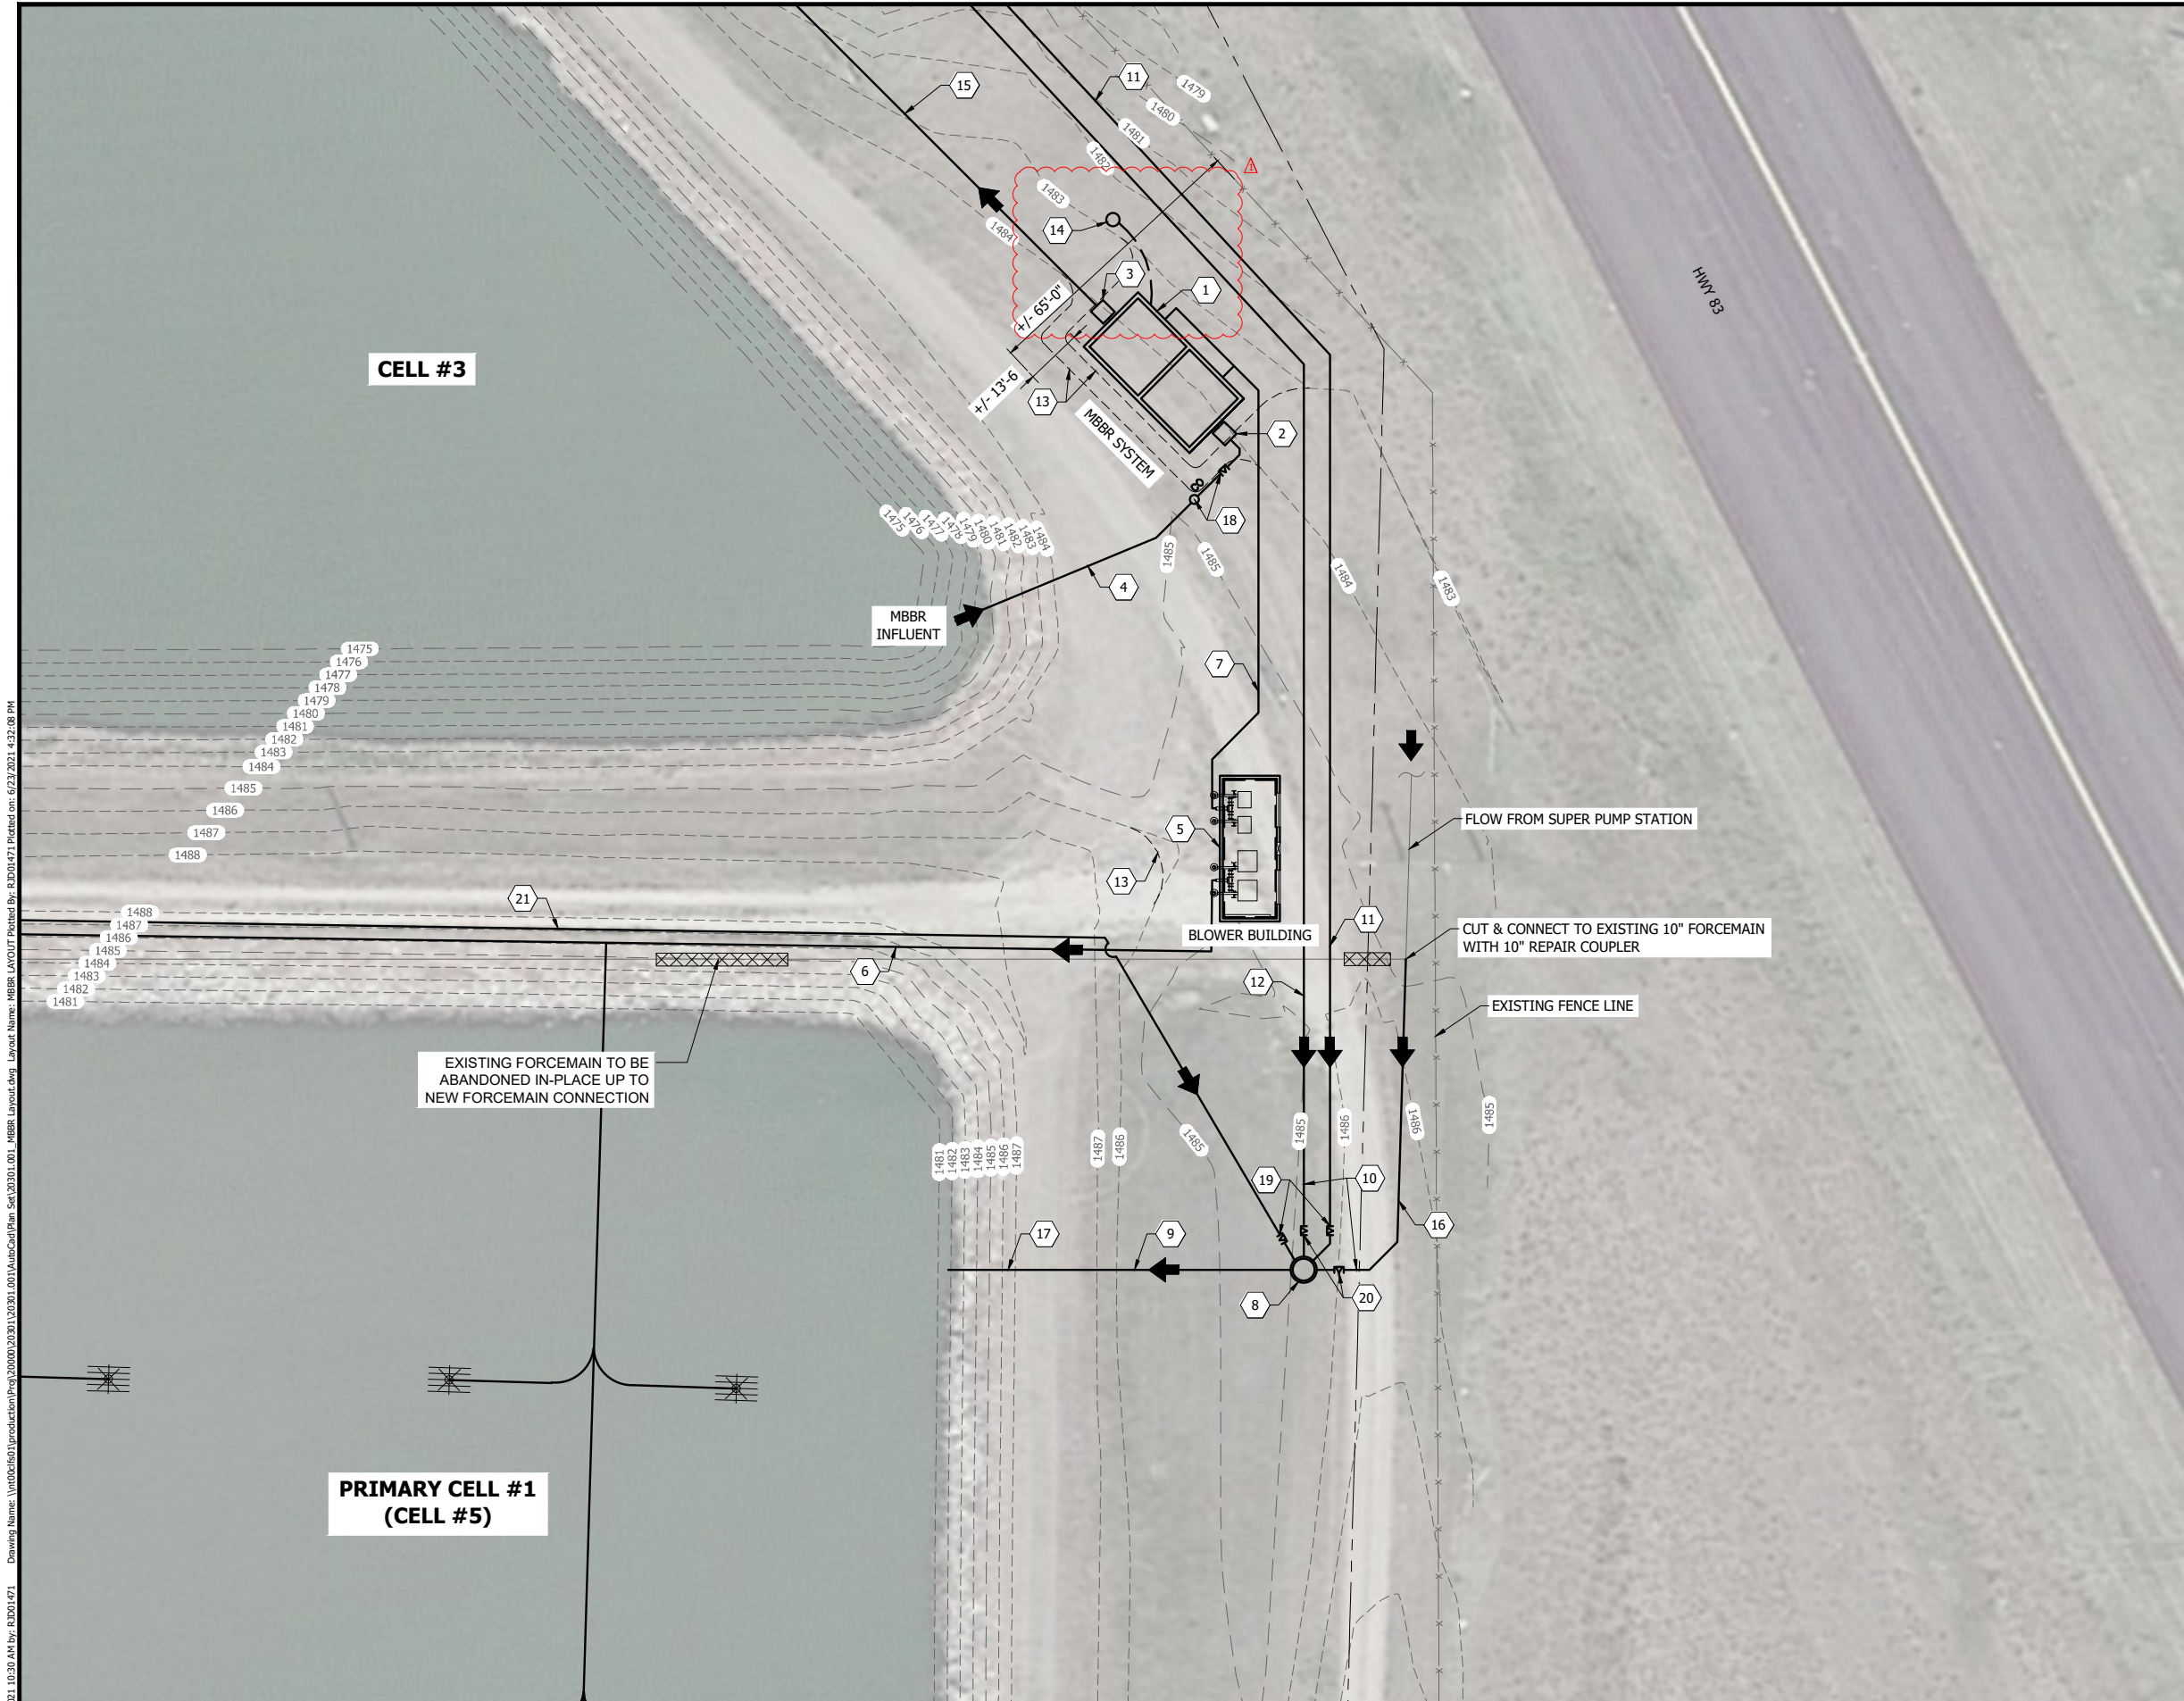

INFLUENT, MBBR AND BLOWER BUILDING
SCALE: 1"=20'

GENERAL NOTES

1. MINIMUM BURY DEPTH OF ALL FORCEMAINS TO BE 6 FEET.
2. ALL FORCEMAIN AND GRAVITY SEWER TO BE PVC SDR 21 UNLESS NOTED OTHERWISE.

REFERENCE NOTES

- 1 CONCRETE MBBR TANKS #1 & #2, SEE REFERENCE SHEET X102 & STRUCTURAL SHEET S100.
- 2 MBBR INFLUENT STRUCTURE, SEE SHEET D302 FOR DETAILS
- 3 MBBR EFFLUENT STRUCTURE, SEE SHEET D303 FOR DETAILS
- 4 MBBR INFLUENT PIPING FROM CELL #3 TO MBBR TANKS, 12" PVC, 70 LF. SEE DETAIL SHEET D301
- 5 MBBR AND AERATOR BLOWERS AND BLOWER BUILDING, SEE SHEET D100
- 6 LAGOON AIR HEADER (630 LF OF 8" DIP, 670 LF OF 4" HDPE) 4' MIN BURY DEPTH
- 7 MBBR AIR HEADER, 145 LF OF 8" DIP, 4' MIN BURY DEPTH
- 8 NEW CELL #1 FM INTAKE MH (6'-0" Ø)
TOP OF MH ELEV = 1487.00'
FL IN (3")=1483.00' (QTY 1)
FL IN (4")=1483.00' (QTY 1)
FL IN (10")=1482.50' (QTY 2)
FL OUT (16")=1481.50'
- 9 16" DR 18, C905, INFLUENT PIPING INTO CELL #1, +/- 100 LF, SEE SHEET D301
- 10 NEW AIR/VAC RELEASE ASSEMBLY, TAP 10" FM PRIOR TO VALVE, (QTY 2) SEE DETAIL SHEET C501
- 11 RECIRCULATION LINE TO FM INTAKE MH NEAR NEW CELL #1, SEE SHEET C101 FOR LINE LENGTH
- 12 EXTEND 10" PVC FORCEMAIN FROM NEAR CELL #4 TO NEW CELL #1 INTAKE MH, SEE SHEET C103 FOR LINE LENGTH
- 13 GRADE SITE TO DRAIN AND NEW ELEVATIONS SHOWN.
- 14 4" DRAIN LINE (PERFORATED HDPE W/ SOCK) AROUND OUTSIDE PERIMETER AT BOTTOM OF MBBR TANKS (ELEV=1468.5') EXTEND TO SUMP PIT, SEE DETAIL ON SHEET C500
- 15 MBBR EFFLUENT PIPING TO NEW 4' CONC MH/ CELL #4, 12" PVC, 520 LF @ 0.22%.
- 16 NEW 10" PVC FORCEMAIN TO NEW CELL #1 INTAKE MH, +/- 100 LF
- 17 PROVIDE CELL SLOPE PENETRATION AND COMPACT EMBANKMENT, SEE DETAIL ON SHEET D301
- 18 12" PLUG VALVE AND BOX AND 12" CLEANOUT
- 19 3" OR 4" PLUG VALVE AND BOX (QTY 2)
- 20 10" PLUG VALVE AND BOX (QTY 2)
- 21 NEW WAGON WHEEL 3" FM EXTENSION TO INTAKE MH, SEE SHEET C101 FOR LINE LENGTH

Bartlett & West


1200 SW EXECUTIVE DRIVE - TOPEKA, KS 66615-3850
PHONE 785.272.2252 - FAX 785.273.8735
www.bartlettwest.com

**INFLUENT, MBBR AND BLOWER BUILDING
OVERALL LAYOUT**


**FORT PIERRE WASTEWATER
TREATMENT IMPROVEMENTS
FORT PIERRE, SD**



DESIGNED BY:	MNB
DRAWN BY:	RJD
APPROVED BY:	RTK
DESIGN PROJ:	20301.001
CONST PROJ:	20301.001
SCALE:	AS NOTED
DATE:	05-06-2021
DRAWING NO:	C102
SHEET NO:	8 of 43

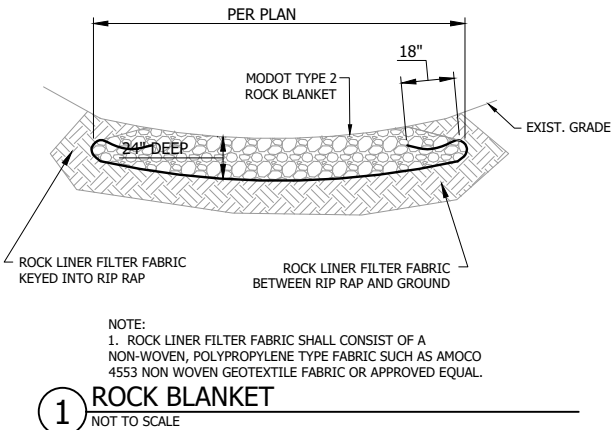


- EROSION CONTROL PHASING**
1. The project is to be constructed in a single phase.
 2. Contractor may begin construction activities as soon as the erosion control measures are installed and approved.
 3. Contractor shall build the silt fence shown on the plans and in accordance to the SWPPP and shall take care that all areas disturbed during construction drain to the fences installed.
 4. All erosion control measures shall remain in place for the duration of the construction project.

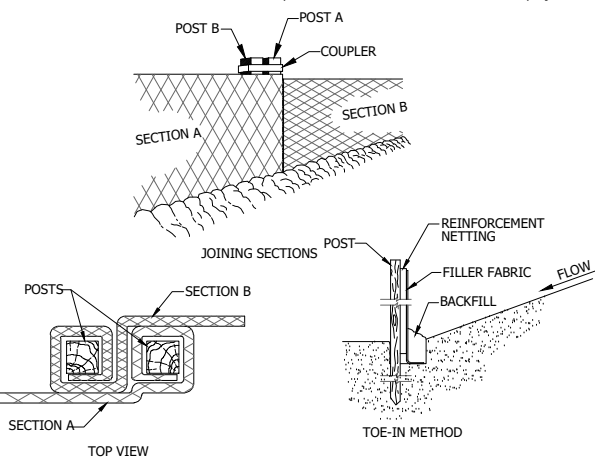

1. EXCAVATE A 6"x 6" TRENCH ALONG THE TOE OF SLOPE.
2. UNROLL ONE SECTION AT A TIME AND POSITION POSTS AGAINST THE DOWNSTREAM WALL OF THE TRENCH. REINFORCEMENT NETTING MUST BE ON DOWNSTREAM SIDE OF FLOW DIRECTION.
3. DRIVE POST INTO THE GROUND UNTIL THE REINFORCEMENT NETTING IS APPROXIMATELY 2' FROM THE TRENCH BOTTOM.
4. LAY THE TOE-IN FLAP OF THE FABRIC IN THE BOTTOM OF THE TRENCH, AND TAMP THE SOIL.
5. DOWNSTREAM END OF SILT FENCE SHALL BE TURNED INTO BACKSLOPE TO FORM ENCLOSURE.


4 SILT FENCE INSTALLATION

NOT TO SCALE

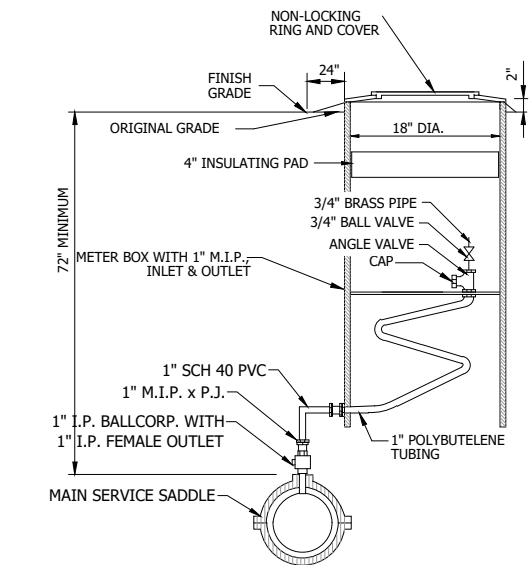

5 MANUAL AIR/VAC RELEASE ASSEMBLY

NOT TO SCALE

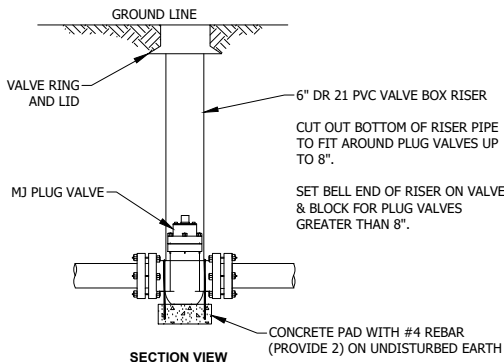


GENERAL NOTES:

1. ANCHOR COUPLING OR PVC PIPE WITH TIEBACK RODS WILL BE REQUIRED BETWEEN VALVE AND FITTINGS.
2. WRAP VALVE AND JOINTS WITH VISQUEEN.
3. VALVE AND RISER SHALL BE PLUMB AND CHECKED BY A LEVEL.
4. IF VALVE BOX IS LOCATED IN PAVEMENT, VALVE BOX SHALL BE CAST IRON TWO PIECE ADJUSTABLE SCREW TYPE VALVE BOX WITH DROP LID (5 1/4" SHAFT)


2 PLUG/GATE VALVE AND BOX

NOT TO SCALE

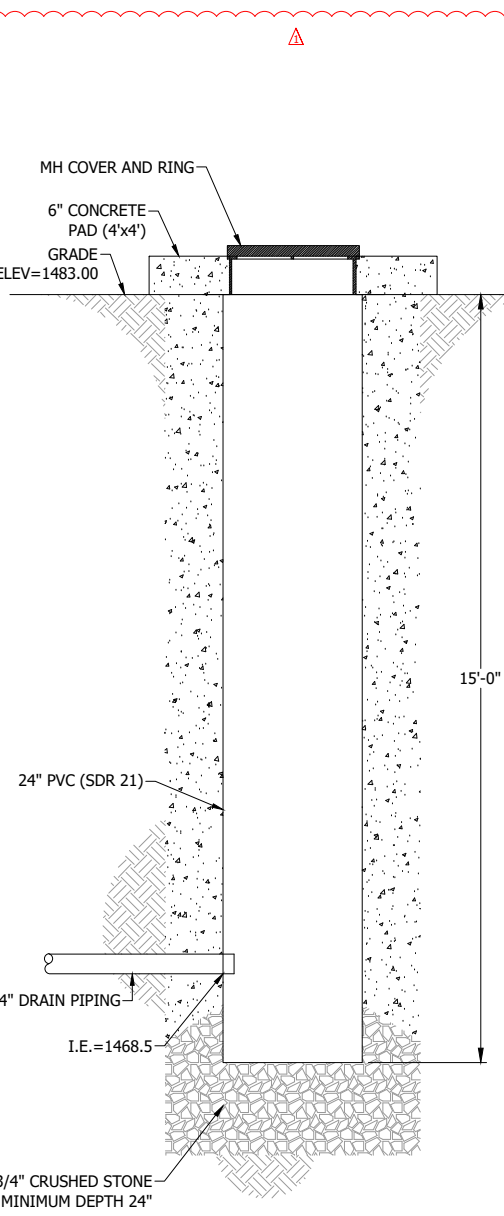


6 SUMP PIT DETAIL

NOT TO SCALE

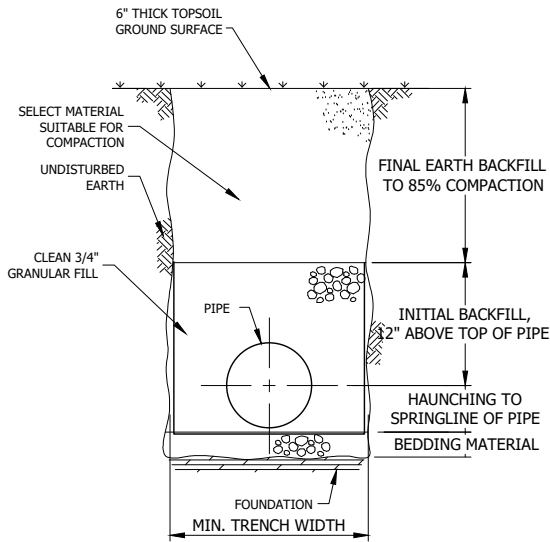


TYPICAL TRENCH CROSS SECTION

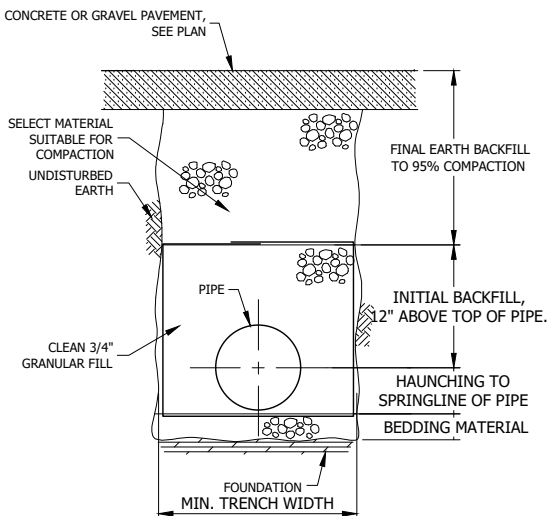

TYPICAL TRENCH CROSS-SECTION- PAVED SURFACE

3 PIPE TRENCH DETAIL

NOT TO SCALE

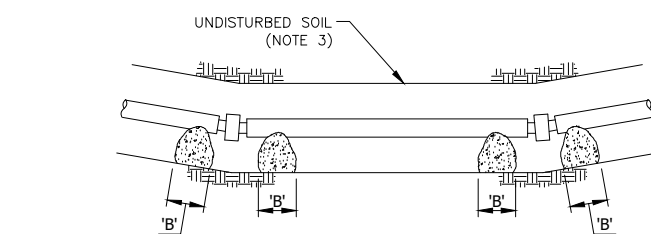

7 TYPICAL THRUST BLOCKING AT DEFLECTED COUPLINGS

NOT TO SCALE

NOMINAL DIA. (IN)	DEAD END / TOP	HORIZONTAL THRUST BLOCK SCHEDULE				VERTICAL THRUST BLOCK SCHEDULE					
		MINIMUM BEARING SURFACE (SQ FT)				MINIMUM BLOCK VOLUME (CU FT)					
		BENDS				BENDS					
		11 25°	22 5°	45°	90°	3°	4°	5°	11 25°	22 5°	45°
3	1.4	0.9	0.9	1.1	2.0	0	1	1	2	4	7
4	2.2	0.9	0.9	1.7	3.1	1	1	1	3	6	10
6	4.8	0.9	1.9	3.7	6.8	2	2	3	6	12	23
8	8.6	1.7	3.4	6.6	12.2	3	4	5	11	22	41
10	13.2	2.6	5.1	10.1	18.6	5	6	8	17	34	62
12	18.8	3.7	7.3	14.4	26.6	7	9	11	24	48	89
14	25.6	5.0	10.0	19.6	36.2	9	12	15	33	65	121
16	33.3	6.5	13.0	25.4	47.0	12	15	19	43	85	157
18	42.0	8.2	16.4	32.1	59.4	15	20	24	55	107	198
20	51.7	10.1	20.2	39.5	73.1	18	24	30	67	132	244
24	74.5	14.6	29.1	57.0	105.3	26	35	43	97	190	351
30	115.6	22.7	45.1	88.4	163.4	40	54	67	150	295	545
36	166.0	32.5	64.8	127.1	234.8	58	77	96	216	424	783

DESIGN CRITERIA:

PIPE PRESSURE (TEST) = 100 PSI
SOIL BEARING CAPACITY = 1,000 LB / SQ FT
UNIT WEIGHT OF CONCRETE = 150 LB / CU FT
SAFETY FACTOR = 1.5

THRUST BLOCK NOTES:

1. THRUST BLOCKS SHALL MEET THE MINIMUM AREA OR VOLUME REQUIREMENT SHOWN IN SCHEDULES. ALIGNMENT ANGLES REQUIRING MULTIPLE FITTINGS SHALL HAVE ONE BLOCK PER FITTING.
2. THRUST FORCE WAS CALCULATED USING PRESSURE AND BEARING CAPACITY ESTABLISHED IN DESIGN CRITERIA. CONTRACTOR SHALL SCALE MINIMUM VALUES APPROPRIATELY BASED ON TEST PRESSURES IDENTIFIED IN BID DOCUMENTS AND SITE CONDITIONS. (E.G. A 200 PSI PRESSURE REQUIRES TWICE (X2) THE BEARING SURFACE OF A 100 PSI PRESSURE; LIKEWISE ALLUVIAL SOIL REQUIRES HALF (-2) THE BEARING SURFACE OF SOFT CLAY.) CONTRACTOR SHALL INCREASE SAFETY FACTOR IF REQUIRED BY JURISDICTIONAL CODE.
3. EXTEND THRUST BLOCKS TO UNDISTURBED SOIL. EXCAVATION INTO TRENCH WALL MAY BE NECESSARY. WHERE NOT POSSIBLE, BEAR AGAINST FILL COMPACTED TO AT LEAST 95% STANDARD PROCTOR DENSITY.
4. BLOCK HEIGHT (H) SHALL BE CHOSEN SUCH THAT CALCULATED BLOCK WIDTH (B) VARIES BETWEEN ONE (1) AND TWO (2) TIMES THE BLOCK HEIGHT. MIN BLOCK HEIGHT SHALL NOT BE LESS THAN PIPE DIAMETER (D).
5. USE STATE DOT CLASS C CONC. ONLY FORM VERTICAL SURFACES OF POURED CONC BLOCKS NOT ON BEARING SURFACE. ENCASE ALL FITTINGS IN AWWA C105 POLYETHYLENE WRAP (8 MIL MIN). DO NOT ALLOW CONC TO DIRECTLY CONTACT JOINTS OR FITTING BOLTS.
6. COAT REBAR WITH BITUMASTIC COMPOUND (SYSTEM 10, SECTION 099000).


BEARING CAPACITIES OF UNDISTURBED MATERIAL (LB / SQ FT)	
Muck	0
Clay, Soft	1,000
Sand, Quick	1,000
Silt	1,500
Alluvial Soil	2,000
Sand, Fine & Loose	2,000
Sandy Silt	3,000
Sand, Clean & Dry & Med Comp.	4,000
Sandy Clay	6,000
Clay, Moderately Dry	6,000
Sand, Compacted Firm	8,000
Clay, Dry	9,000
Hardpan	9,000
Cemented Sand/Gravel	10,000
Brick - Poor Condition	10,000
Brick - Good Condition	30,000
Ledge Rock	50,000
Rock - Good Masonry	60,000
Granite	100,000

References:
DIPRA. Thrust Restraint Design. 2002.
DIPRA. Handbook of Ductile Iron Pipe. 1984.
Uni-Bell. Handbook of PVC Pipe. 1991.

TRENCH NOTES:


1. FOUNDATION: WHERE THE TRENCH BOTTOM IS UNSTABLE, THE CONTRACTOR SHALL EXCAVATE TO A DEPTH REQUIRED BY THE ENGINEER AND REPLACE WITH A FOUNDATION OF CLASS I OR II MATERIAL AS DEFINED IN ASTM D2321, "STANDARD PRACTICE FOR INSTALLATION OF THERMOPLASTIC PIPE FOR SEWERS AND OTHER GRAVITY-FLOW APPLICATIONS", LATEST EDITION; AS AN ALTERNATIVE AND AT THE DISCRETION OF THE ENGINEER, THE TRENCH BOTTOM MAY BE STABILIZED USING A WOVEN GEOTEXTILE FABRIC.
2. BEDDING: SUITABLE MATERIAL SHALL BE CLASS I, II OR III AND INSTALLED AS REQUIRED IN ASTM D2321, LATEST EDITION UNLESS OTHERWISE SPECIFIED BY THE ENGINEER, MINIMUM BEDDING THICKNESS SHALL BE 4" (100mm) FOR 4"-24" (100-600mm) PIPE; 6" FOR 30"-60" (750-1500mm) PIPE.
3. HAUNCHING AND INITIAL BACKFILL: SUITABLE MATERIAL SHALL BE CLASS I, II OR III AS REQUIRED IN ASTM D2321, LATEST EDITION.
4. UNLESS OTHERWISE SPECIFIED BY THE ENGINEER, MINIMUM TRENCH WIDTHS SHALL BE AS FOLLOWS:

NOMINAL in (mm)	MIN. RECOMMENDED TRENCH WIDTH, in (mm)
4 (100)	21 (530)
6 (150)	23 (580)
8 (200)	25 (630)
10 (250)	28 (710)
12 (300)	31 (790)
15 (375)	34 (860)
18 (450)	39 (990)
24 (600)	48 (1220)
30 (750)	66 (1680)
36 (900)	78 (1980)

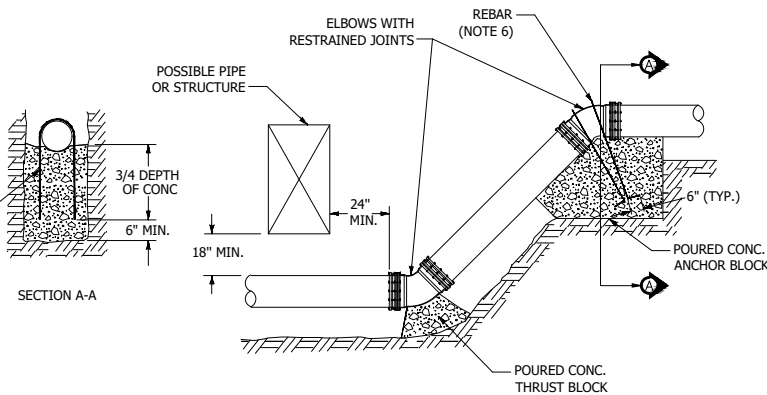


8 TYPICAL THRUST BLOCKS FOR CHANGES IN PIPE DEPTH

NOT TO SCALE

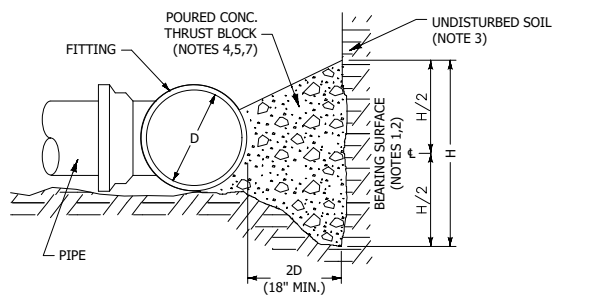

9 TYPICAL THRUST BLOCK SECTION

NOT TO SCALE

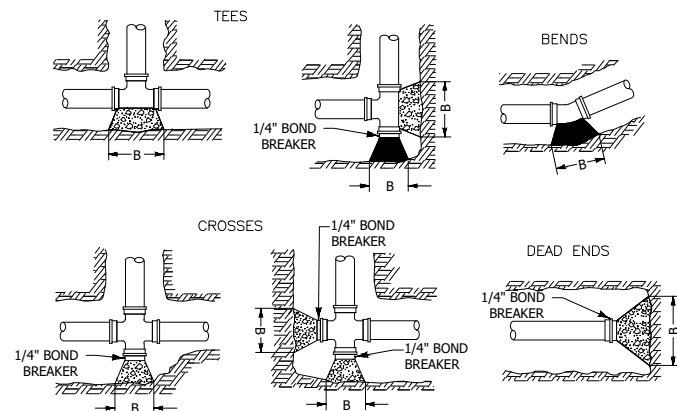

10 TYPICAL THRUST BLOCK PLAN

NOT TO SCALE

Bartlett & West

CIVIL DETAILS

FORT PIERRE WASTEWATER TREATMENT IMPROVEMENTS

FORT PIERRE, SD




DESIGNED BY: MNB
DRAWN BY: RJD
APPROVED BY: RTK
DESIGN PROJ: 20301.001
CONST PROJ: 20301.001
SCALE: AS NOTED
DATE: 05-06-2021
DRAWING NO: **C500**
SHEET NO: 37 of 43

Last edit on: 6/23/2021 10:30 AM by: R201471 Drawing Name: \\triplepoint\production\proj\20301\20301.001\Aeration\Plan Set\20301.001_TripPoint Reference Drawings.dwg Layout Name: Layout1 Plotted on: 6/23/2021 4:35:18 PM

6/18/2021 4:32 PM

- NOTES:
- EXISTING CONDITIONS ARE TAKEN FROM AERIAL PHOTOGRAPHS, FIELD OBSERVATIONS, AND/OR PRIOR CONSTRUCTION DOCUMENTS, WHEN AVAILABLE. CONTRACTOR SHALL FIELD VERIFY ALL EXISTING CONDITIONS.
 - SEE ENGINEERING PLANS AND SPECIFICATIONS FOR PIPING DETAILS.
 - CONTRACTOR SHALL EVENLY DISTRIBUTE AERATORS THROUGHOUT LAGOON USING GIVEN DIMENSIONS AS A GUIDELINE.
 - CONTRACTOR SHALL EVENLY SPACE MANIFOLDS ALONG HEADER USING GIVEN DIMENSIONS AS A GUIDELINE.

AERATION LAYOUT
FORT PIERRE, SD

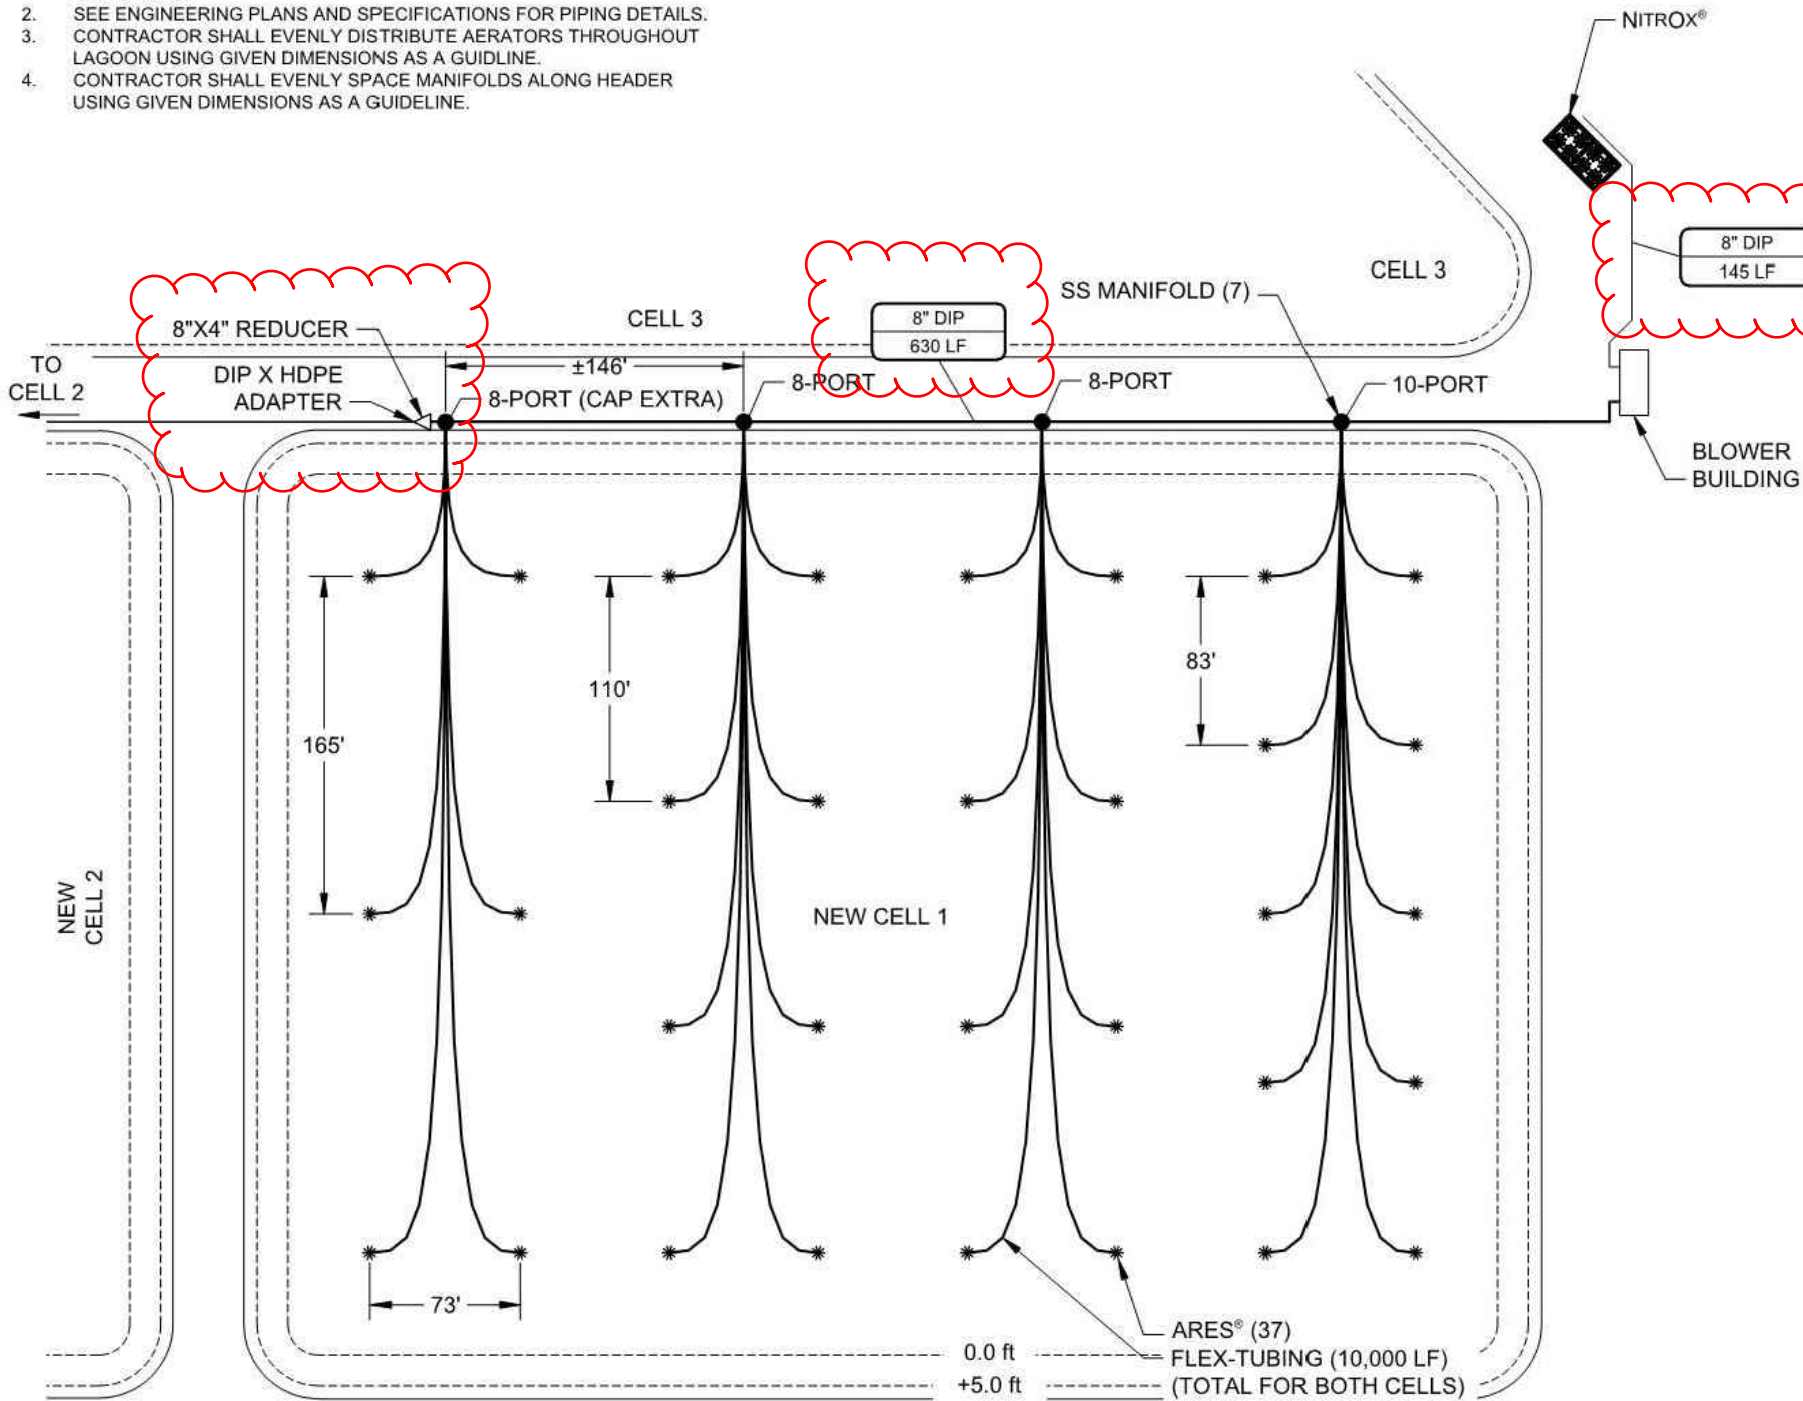

PLAN VIEW

SCALE: 1"=80'


0 40' 80'

TYPICAL SCOPE OF SUPPLY

ITEM	DESCRIPTION	TPE	BYO
1	BLOWERS	X	
2	BLOWER PADS/BUILDING		X
3	HEADER PIPING & VALVES		X
4	LATERALS AND/OR RISER STUBS		X
5	AERATOR CONTROL MANIFOLDS	X	
6	AERATOR CONTROL VALVES	X	
7	FLEXIBLE TUBING	X	
8	AERATORS	X	

TPE = TRIPLEPOINT ENVIRONMENTAL
BYO = BY OTHERS

NOTE: This scope of supply is typical. Check quotation from Triplepoint Environmental, LLC for complete scope of supply.

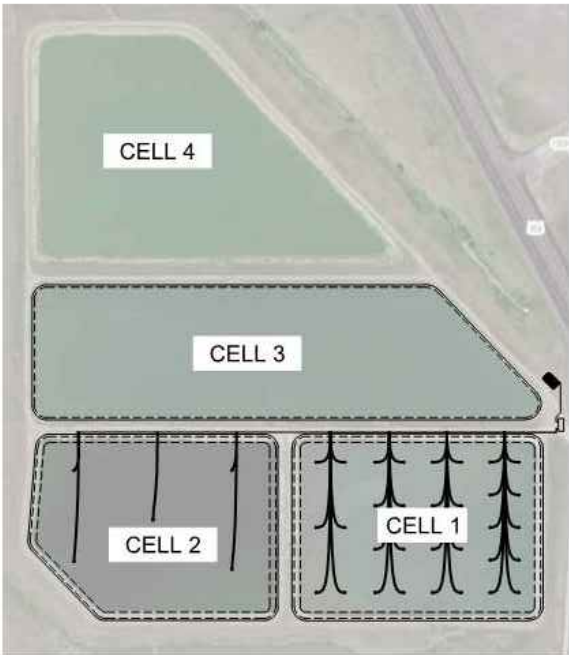

SITE PLAN
SCALE: NTS



TRIPLEPOINT
ENVIRONMENTAL, LLC
100 LAKE STREET, SUITE 503, OAK PARK, IL 60301
(312) 439-4034

REV	DATE	DESCRIPTION
1	5/14/2019	DESIGN
2	7/17/2020	REVISED AERATOR COUNT
3	7/17/2020	REVISED AERATOR COUNT
4	7/17/2020	ADDED DRAWINGS FOR CELL 3
5	7/17/2020	ADDED DRAWINGS FOR CELL 4
6	7/17/2020	ADDED DRAWINGS FOR CELL 1
7	7/17/2020	ADDED DRAWINGS FOR CELL 2
8	7/17/2020	ADDED DRAWINGS FOR CELL 3
9	7/17/2020	ADDED DRAWINGS FOR CELL 4
10	7/17/2020	ADDED DRAWINGS FOR CELL 1
11	7/17/2020	ADDED DRAWINGS FOR CELL 2
12	7/17/2020	ADDED DRAWINGS FOR CELL 3
13	7/17/2020	ADDED DRAWINGS FOR CELL 4

FORT PIERRE, SD
PROPOSED AERATION
IMPROVEMENTS

AERATION LAYOUT

DATE: 5/14/2019
PROJECT NO: 20301.001
CAD: FT PIERRE LAYOUT
SHEET: 1 OF 2

REFERENCE DRAWING
TRIPLE POINT
AERATION LAYOUT
FORT PIERRE WASTEWATER
TREATMENT IMPROVEMENTS
FORT PIERRE, SD

REFERENCE DWG

DESIGNED BY: MNB
DRAWN BY: RJD
APPROVED BY: RTK
DESIGN PROJ: 20301.001
CONST PROJ: 20301.001
SCALE: AS NOTED
DATE: 05-06-2021
DRAWING NO: X100
SHEET NO: 32 OF 43


Last edit on: 6/23/2021 10:30 AM by: R201471 Drawing Name: \\triplepoint\production\proj\20301\20301.001\AerationLayout.dwg Layout Name: Layout1 (A) Plotted on: 6/23/2021 4:36:32 PM

6/18/2021 4:32 PM

NOTES:

1. EXISTING CONDITIONS ARE TAKEN FROM AERIAL PHOTOGRAPHS, FIELD OBSERVATIONS, AND/OR PRIOR CONSTRUCTION DOCUMENTS, WHEN AVAILABLE. CONTRACTOR SHALL FIELD VERIFY ALL EXISTING CONDITIONS.
2. SEE ENGINEERING PLANS AND SPECIFICATIONS FOR PIPING DETAILS.
3. CONTRACTOR SHALL EVENLY DISTRIBUTE AERATORS THROUGHOUT LAGOON USING GIVEN DIMENSIONS AS A GUIDELINE.
4. CONTRACTOR SHALL EVENLY SPACE MANIFOLDS ALONG HEADER USING GIVEN DIMENSIONS AS A GUIDELINE.

AERATION LAYOUT
FORT PIERRE, SD

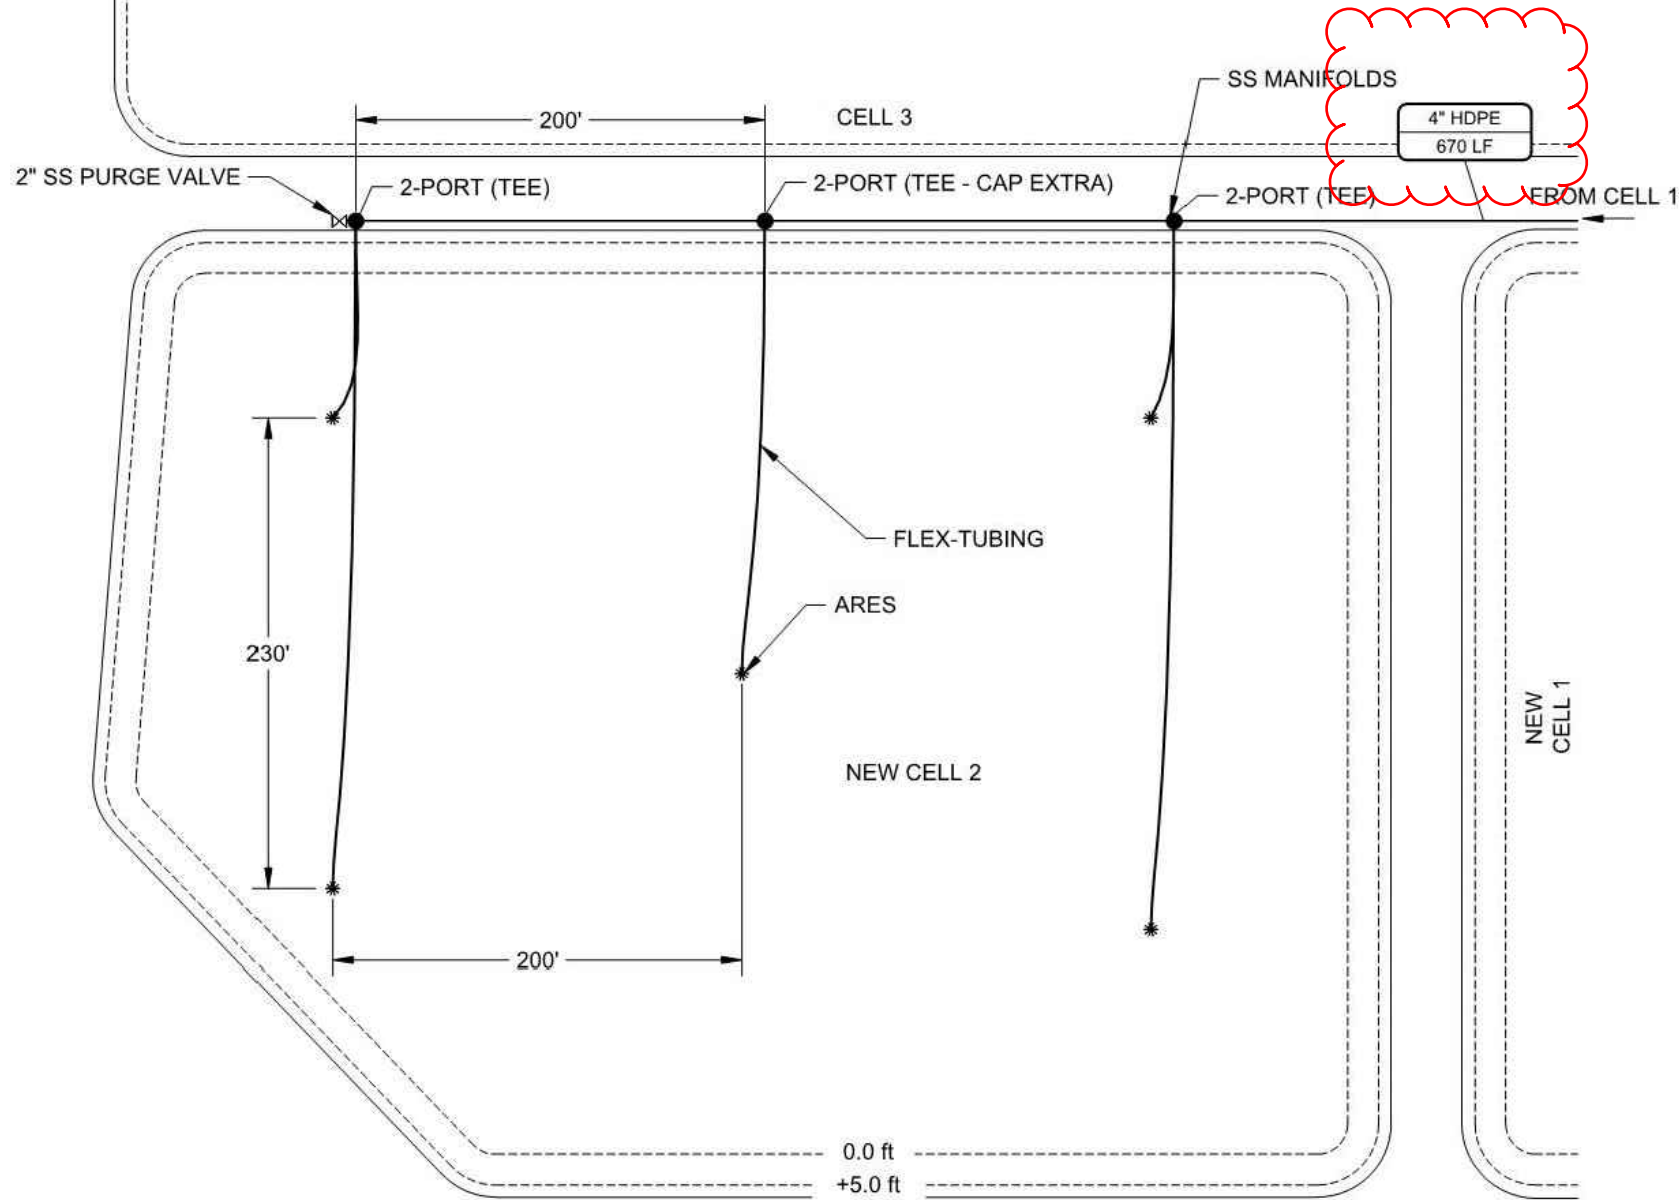

PLAN VIEW

SCALE: 1"=80'


0 40' 80'

TYPICAL SCOPE OF SUPPLY

ITEM	DESCRIPTION	TPE	BYO
1	BLOWERS	X	
2	BLOWER PADS/BUILDING		X
3	HEADER PIPING & VALVES		X
4	LATERALS AND/OR RISER STUBS		X
5	AERATOR CONTROL MANIFOLDS	X	
6	AERATOR CONTROL VALVES	X	
7	FLEXIBLE TUBING	X	
8	AERATORS	X	

TPE = TRIPLEPOINT ENVIRONMENTAL
BYO = BY OTHERS

NOTE: This scope of supply is typical. Check quotation from Triplepoint Environmental, LLC for complete scope of supply.

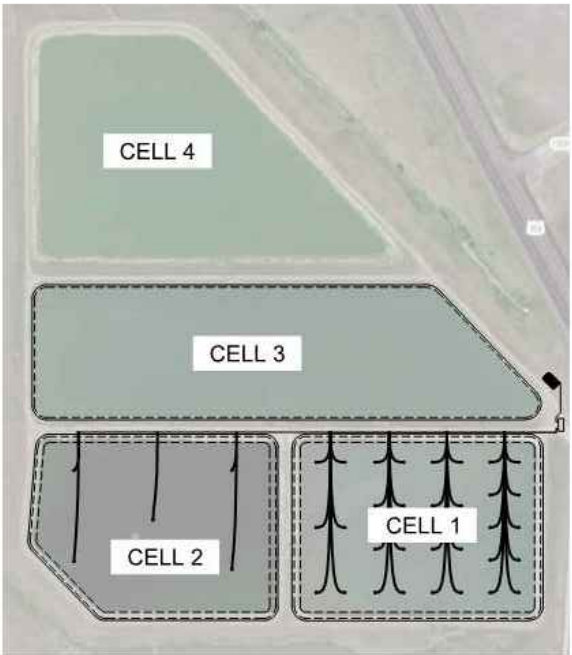

SITE PLAN
SCALE: NTS



TRIPLEPOINT ENVIRONMENTAL, LLC
100 LAKE STREET, SUITE 500, OAK PARK, IL 60301
(312) 439-4034

REV	DATE	DESCRIPTION
1	5/14/2019	DESIGN
2	7/17/2020	REVISED AERATOR COUNT
3	7/17/2020	REVISED AERATOR COUNT
4	7/17/2020	ADDED GRAPHS FOR CELL 3
5	7/17/2020	ADDED GRAPHS FOR CELL 4
6	7/17/2020	ADDED GRAPHS FOR CELL 1
7	7/17/2020	ADDED GRAPHS FOR CELL 2
8	7/17/2020	ADDED GRAPHS FOR CELL 3
9	7/17/2020	ADDED GRAPHS FOR CELL 4
10	7/17/2020	ADDED GRAPHS FOR CELL 1
11	7/17/2020	ADDED GRAPHS FOR CELL 2
12	7/17/2020	ADDED GRAPHS FOR CELL 3
13	7/17/2020	ADDED GRAPHS FOR CELL 4

FORT PIERRE, SD
PROPOSED AERATION
IMPROVEMENTS

AERATION LAYOUT

DATE: 5/14/2019
PROJECT NO:
CAD: FT PIERRE LAYOUT


SHEET:
2 OF 2

Bartlett & West

REFERENCE DRAWING
TRIPLE POINT
AERATION LAYOUT
FORT PIERRE WASTEWATER
TREATMENT IMPROVEMENTS
FORT PIERRE, SD


REFERENCE DWG

DESIGNED BY: MNB
DRAWN BY: RJD
APPROVED BY: RTK
DESIGN PROJ: 20301.001
CONST PROJ: 20301.001
SCALE: AS NOTED
DATE: 05-06-2021
DRAWING NO:
SHEET NO: X101

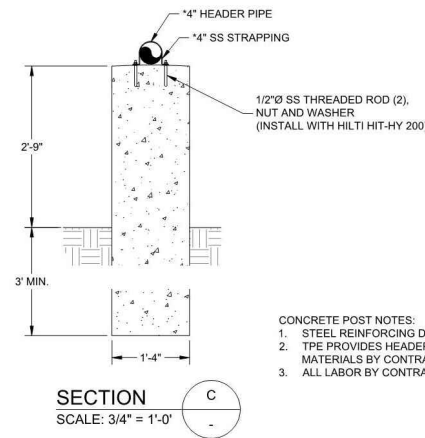

CONCRETE POST NOTES:

1. STEEL REINFORCING DESIGN BY OTHERS.
2. TPE PROVIDES HEADER PIPE AND STRAPPING. ALL OTHER MATERIALS BY CONTRACTOR.
3. ALL LABOR BY CONTRACTOR.

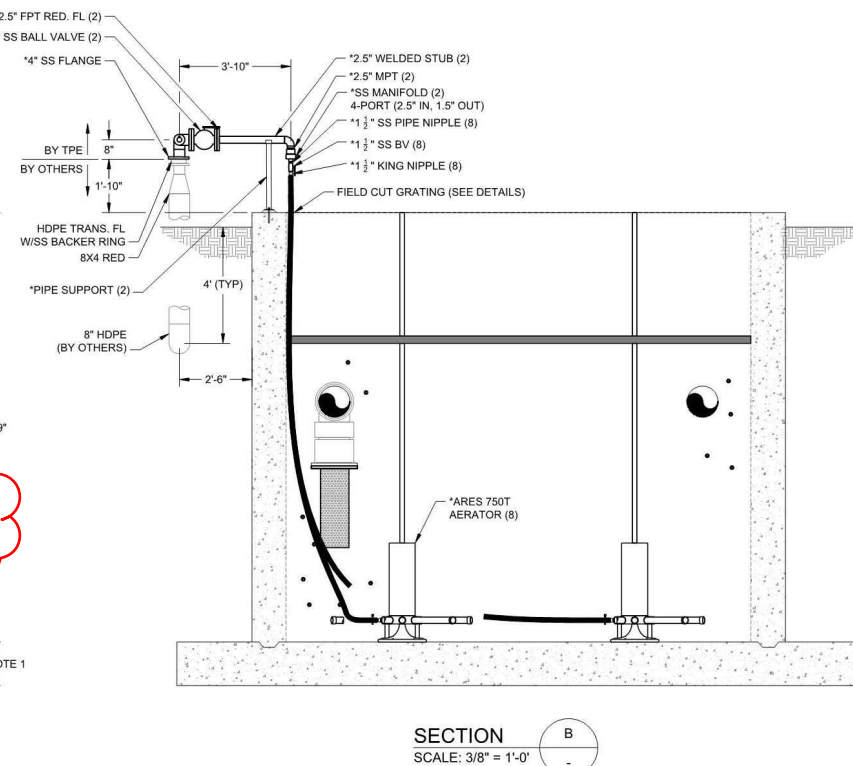

COPYRIGHT 2021 TRIPLEPOINT ENVIRONMENTAL, LLC ALL RIGHTS RESERVED

TYPICAL INSTALLATION ARRANGEMENT		FORT PIERRE, SD WASTEWATER TREATMENT SYSTEM GENERAL ARRANGEMENT		<table><tr><th colspan="3">REVISIONS</th></tr><tr><th>DATE</th><th>DESCRIPTION</th><th>REV #</th></tr><tr><td>3/19/20</td><td>PRELIMINARY LAYOUT</td><td>A</td></tr><tr><td>8/11/20</td><td>CHANGE AERATOR DESIGN</td><td>B</td></tr><tr><td>9/3/20</td><td>REVISE AERATOR LAYOUT</td><td>C</td></tr><tr><td>12/23/20</td><td>UPDATED FOR BID</td><td>D</td></tr><tr><td>4/1/21</td><td>CERTIFIED</td><td>E</td></tr><tr><td>6/18/2021</td><td>TODIFLEX BY TPE</td><td>F</td></tr></table>		REVISIONS			DATE	DESCRIPTION	REV #	3/19/20	PRELIMINARY LAYOUT	A	8/11/20	CHANGE AERATOR DESIGN	B	9/3/20	REVISE AERATOR LAYOUT	C	12/23/20	UPDATED FOR BID	D	4/1/21	CERTIFIED	E	6/18/2021	TODIFLEX BY TPE	F
REVISIONS																													
DATE	DESCRIPTION	REV #																											
3/19/20	PRELIMINARY LAYOUT	A																											
8/11/20	CHANGE AERATOR DESIGN	B																											
9/3/20	REVISE AERATOR LAYOUT	C																											
12/23/20	UPDATED FOR BID	D																											
4/1/21	CERTIFIED	E																											
6/18/2021	TODIFLEX BY TPE	F																											
DATE: 3/19/20		PROJECT NO:		CAD: TYPICAL ARRANGEMENT																									
SHEET: 1 OF 2				TRIPLEPOINT ENVIRONMENTAL, LLC 1010 LAKE STREET, SUITE 503, OAK PARK, IL 60301 (312) 498-4634																									

REFERENCE DRAWING
TRIPLE POINT
TYPICAL INSTALLATION ARRANGEMENT
FORT PIERRE WASTEWATER
TREATMENT IMPROVEMENTS
FORT PIERRE, SD

REFERENCE DWG

DESIGNED BY:	MNB
DRAWN BY:	RJD
APPROVED BY:	RTK
DESIGN PROJ:	20301.001
CONST PROJ:	20301.001
SCALE:	AS NOTED
DATE:	05-06-2021
DRAWING NO:	
X103	
SHEET NO:	

Bartlett & West

1200 SW EXECUTIVE DRIVE - TOPEKA, KS 66615.3850
PHONE 785.272.2252 - FAX 785.273.8735
www.bartlettwest.com

ALL RIGHTS RESERVED. ALL PARTS & WEST PLANS, SPECIFICATIONS AND DRAWINGS ARE PROTECTED UNDER COPYRIGHT LAW, AND NO PART MAY BE COPIED, REPRODUCED, DISSEMINATED OR TRANSMITTED IN ANY FORM BY ANY MEANS, WITHOUT PRIOR WRITTEN PERMISSION OF BARTLETT & WEST.